



6100 219th Street SW, Suite 200
 Mountlake Terrace, WA 98043
 Phone 425.744.6267 Fax 425.775.0420
PermitSpecialist@ci.mtl.wa.us
www.cityofmlt.com

SANITARY SEWER APPLICATION

Permit # _____

- Single-Family Residential** **Multi-Family** **Commercial**
 New **Repair**

Job Site Address _____

Description of Work _____

CONTACT INFORMATION

<u>OWNER</u>	
Name	_____
Address	_____
City	_____ State _____ Zip _____
Ph	_____ Fax _____
E-mail	_____
Contact Name	_____
Ph	_____ Fax _____
E-mail	_____

<u>CONTRACTOR</u>	
Name	_____
Address	_____
City	_____ State _____ Zip _____
Ph	_____ Fax _____
E-mail	_____
State Lic. #	_____
City Lic. #	_____

I certify to the best of my knowledge, the information provided on this application is true and correct.

Sign Applicant _____ **Date** _____

Print Applicant _____ **Date** _____

OFFICE USE ONLY

Received By _____ Date _____

Side Sewer Permit Fee \$ _____ Date _____ Receipt Number _____

Capital Improvement Fee \$ _____ Date _____ Receipt Number _____

Sewer Lateral Connection Fee \$ _____ Date _____ Receipt Number _____

Total Balance Due \$ _____ Date _____ Receipt Number _____

Blank area for the side sewer drawing.

OWNER: _____

ADDRESS: _____

DATE: _____

PERMIT #: _____


Inspector's Signature: _____

SIDE SEWER DRAWING

1. Drawing must be clearly labeled (streets, north arrow).
2. Indicate location of all piping, cleanouts, manholes or other fixed features.
3. Dimension pipe length and distance from other features.
4. Label diameter, bends, material type of pipe and depth at cleanouts.



CALL BEFORE YOU DIG:
1-800-424-5555 (or 811)

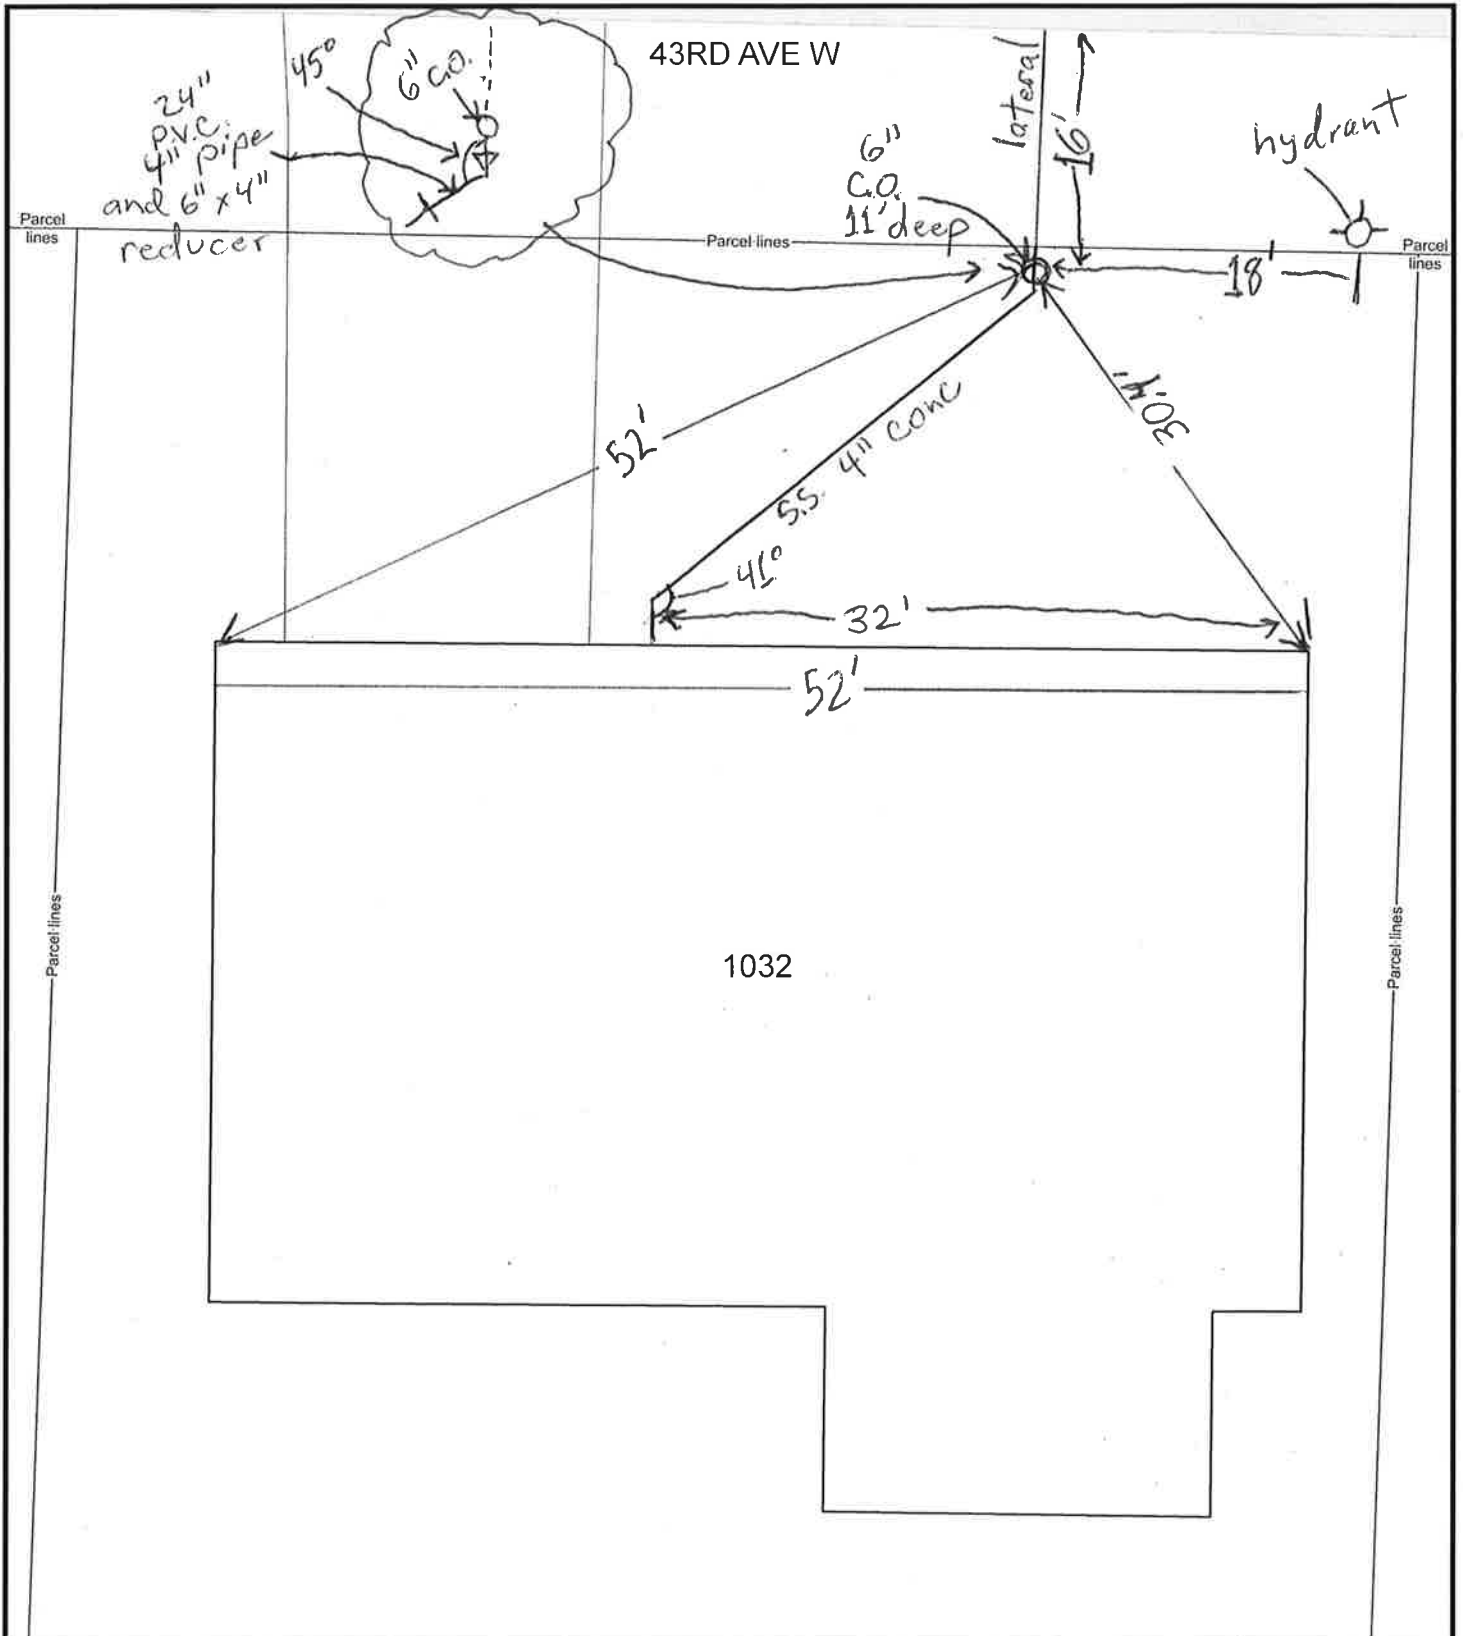

OWNER: Joe Smith

ADDRESS: 1032 43rd Ave W

DATE: 12-31-2015

PERMIT #: U-15-1000

Inspector's Signature: [Signature]

- SIDE SEWER DRAWING EXAMPLE**
1. Drawing must be clearly labeled.
 2. Indicate location of all piping, cleanouts, manholes or other fixed features.
 3. Dimension pipe length and distance from other features.
 4. Label diameter, bends, material type of pipe and depth at cleanouts.



MOUNTLAKE
TERRACE



Not To Scale